


- NOTES
1. This drawing is copyright.

2. All dimensions are to be checked prior to construction or manufacture. Any discrepancy to be reported to the Engineers immediately.

3. Do not scale this drawing, work to figured dimensions only.

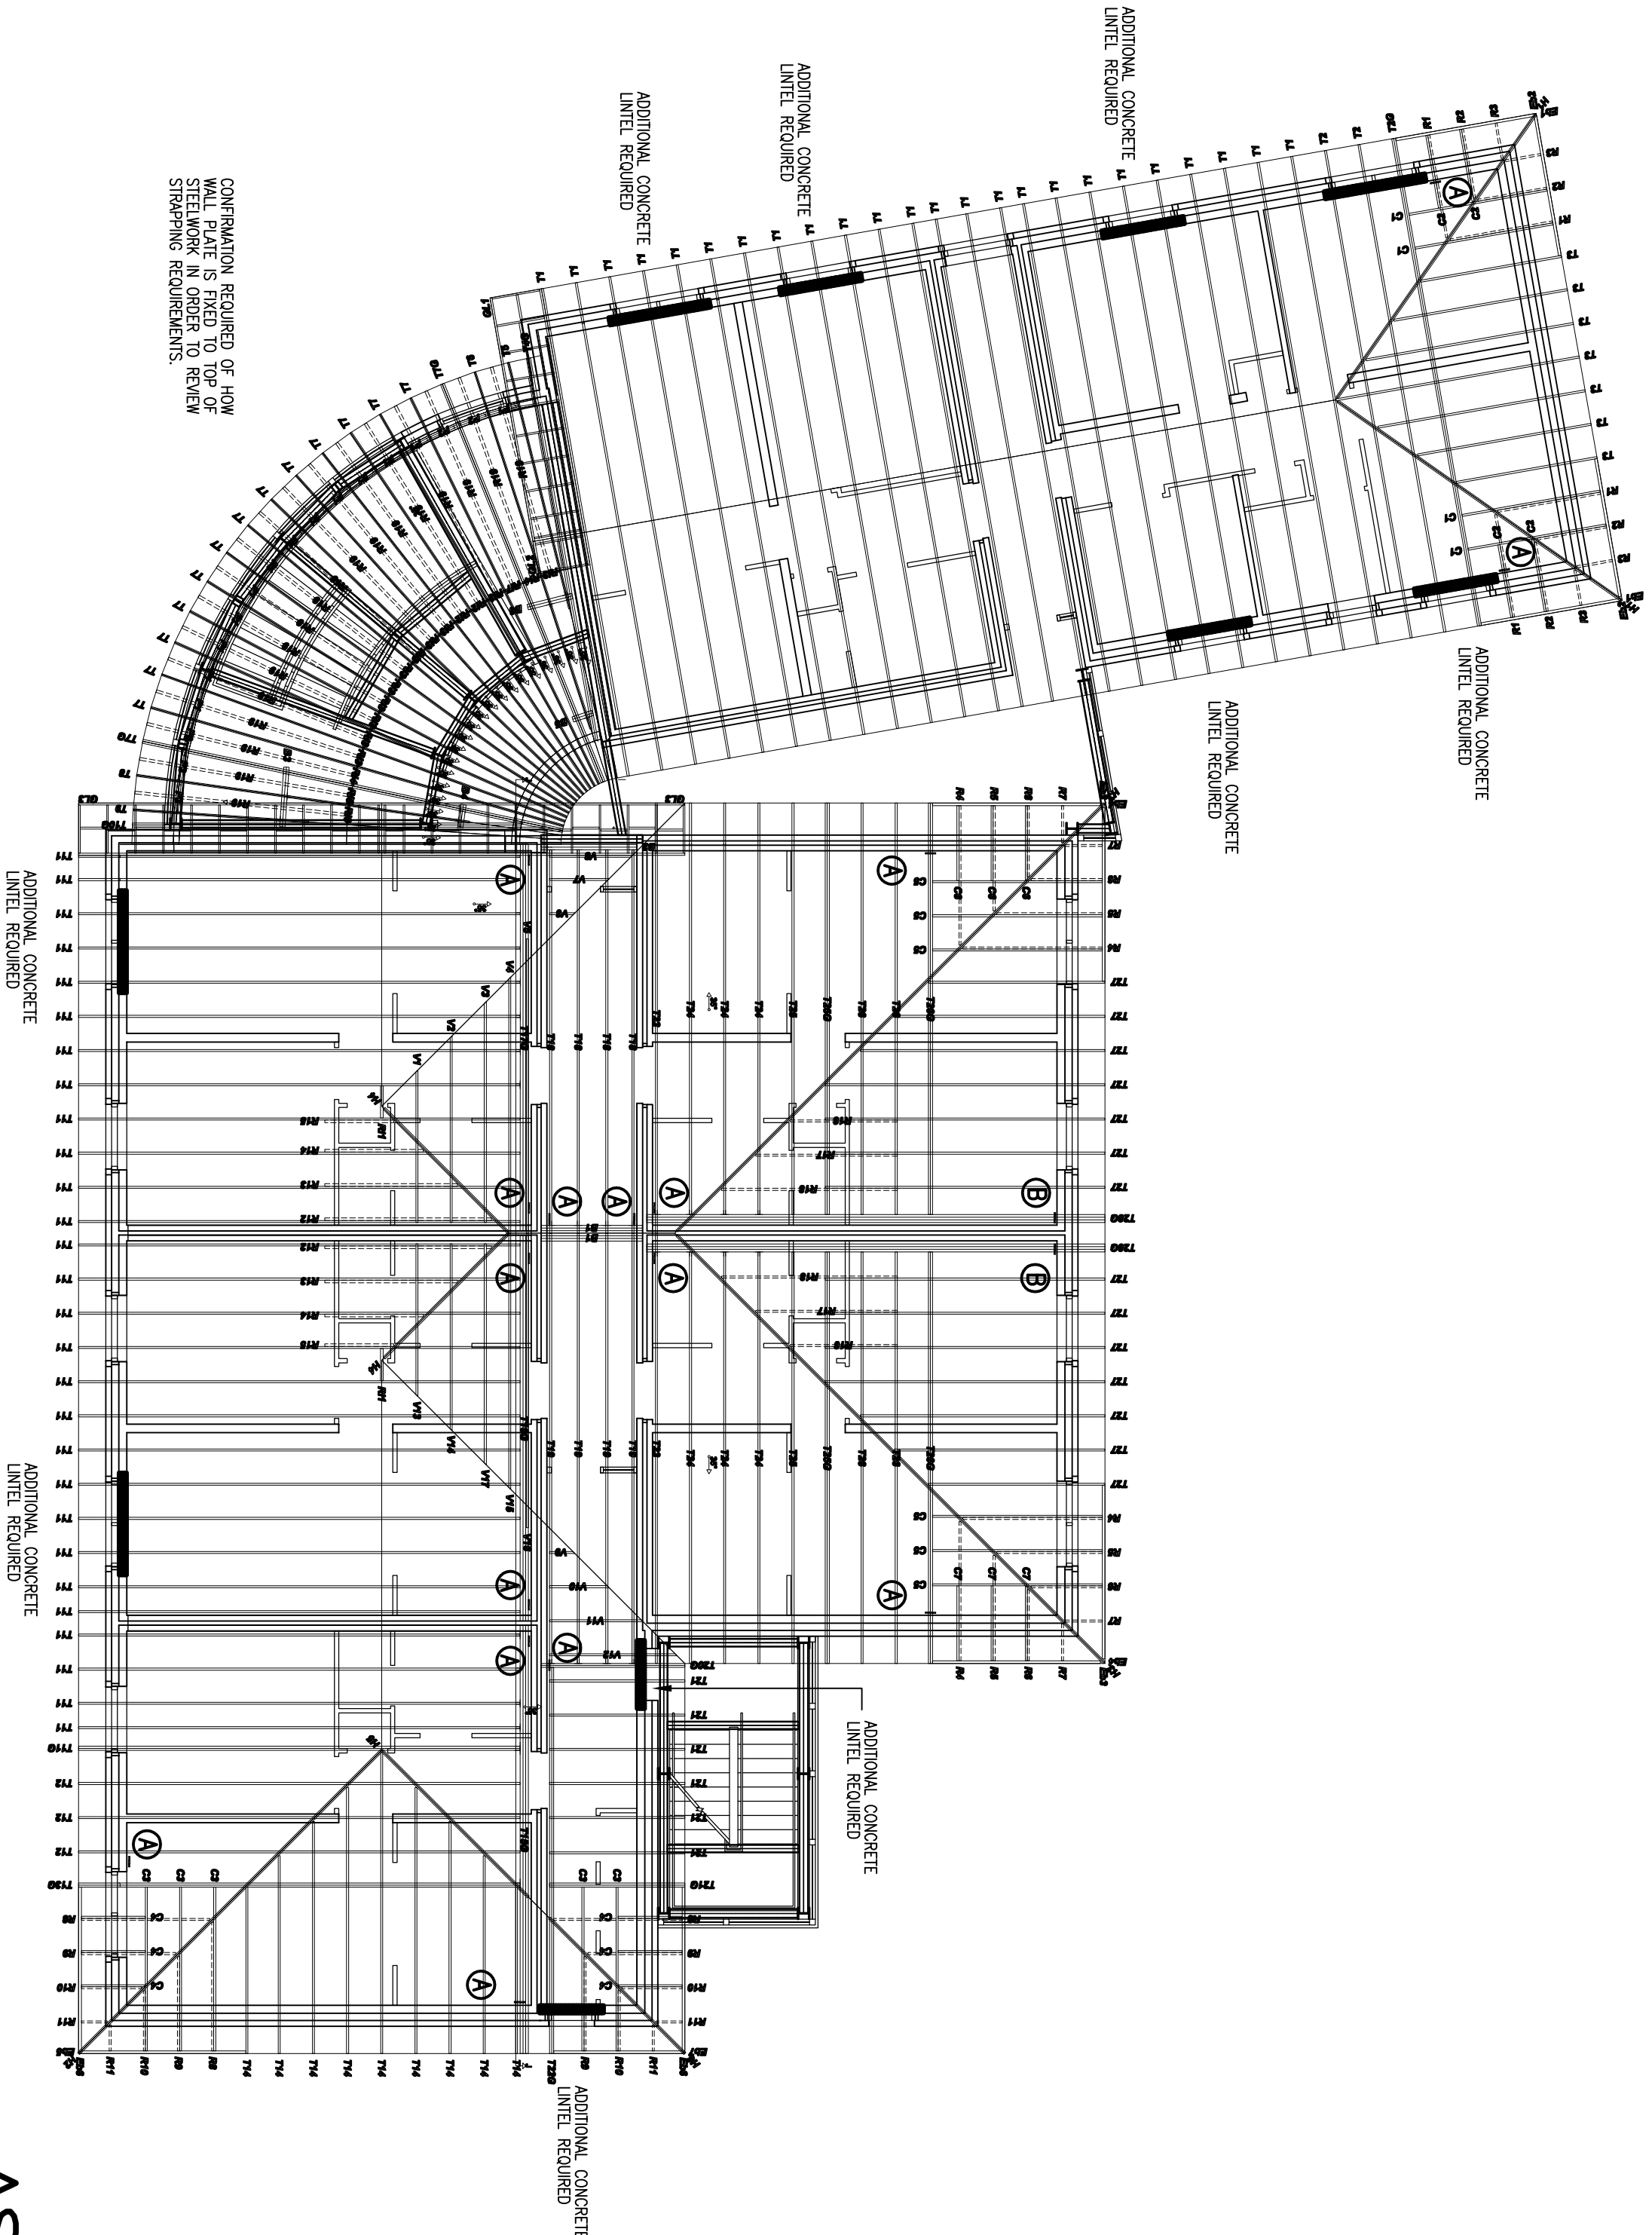

RESTRAINT STRAP TYPE 'A' :  
2400mm LONG STRAPS FIXED TO FACE OF WALL WITH 2 NO. 6mmØ x 45mm LONG TOPCON ( OR SIMILAR APPROVED ) CONCRETE SCREWS IN 5mmØ PRE-DRILLED HOLES.

RESTRAINT STRAP TYPE 'B' :  
2000mm LONG STRAPS FIXED TO FACE OF WALL WITH 5 NO. 6mmØ x 45mm LONG TOPCON ( OR SIMILAR APPROVED ) CONCRETE SCREWS IN 5mmØ PRE-DRILLED HOLES.

NOTE :  
ASSUME TIMBER PLATE TO TOP OF WALL BELOW SPANDREL PANELS/WALLING

ALL OTHER STRAPPING TO BE :  
1200mm LONG STRAPS FIXED TO FACE OF WALL WITH 2 NO. 6mmØ x 45mm LONG TOPCON ( OR SIMILAR APPROVED ) CONCRETE SCREWS IN 5mmØ PRE-DRILLED HOLES. POSITIONED AT 1200mm CENTRES ( EVERY OTHER TRUSS ).

# AS BUILT

SMART ASSOCIATES

Consulting Civil & Structural Engineers

32 Lambourne Crescent

Cardiff Business Park

Ilkesham, Cardiff

CF14 5GG

TEL: 029 20764821

www.smartassociates.biz

Project Title

Drawing Title

DEVELOPMENT AT  
HARRISON DRIVE  
CARDIFF

ROOF STRAPPING  
DOWN PROPOSALS

REV	DATE	BY	REV	DATE	BY	REV	DATE	BY	REV	DATE	BY	REV	DATE	BY	REV	DATE	BY
															AS BUILT ISSUE		
REVISIONS																	

Scales		1:100 @ A2		Drawing Number		REV
Drawn	ov	Checked		Date	05 JUN 2019	
Client		ENCON CONSTRUCTION				
Architect		DANES LLEWELYN AND JONES		S.7683-35		A