



- NOTES
1. This drawing is copyright.
  2. All dimensions are to be checked prior to construction or manufacture. Any discrepancy to be reported to the Engineers immediately.
  3. Do not scale this drawing, work to figured dimensions only.



**FIRST FLOOR PLAN  
SHOWING  
SUPPORT STEELWORK BELOW**

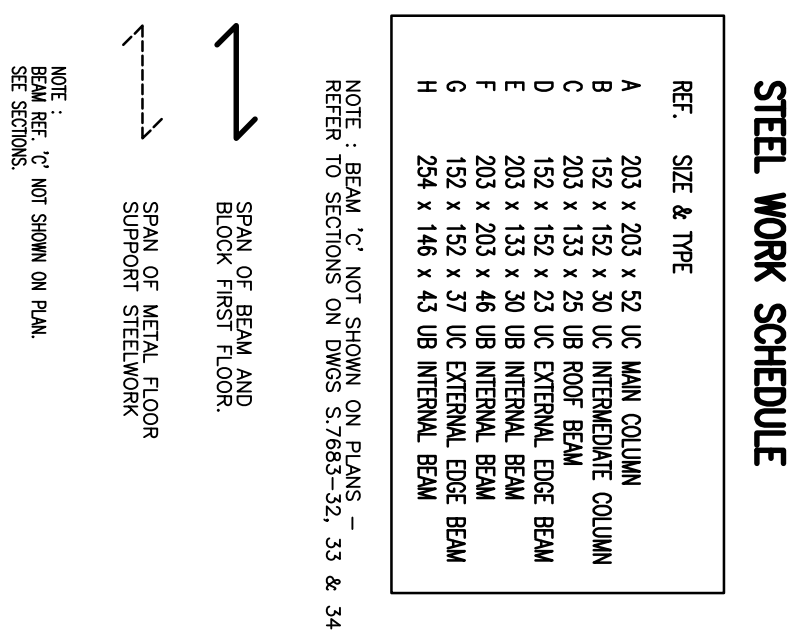


**NOTE : STEELWORK  
ENSURE ALL STEELWORK IS TO  
BE HOT DIPPED GALVANISED**

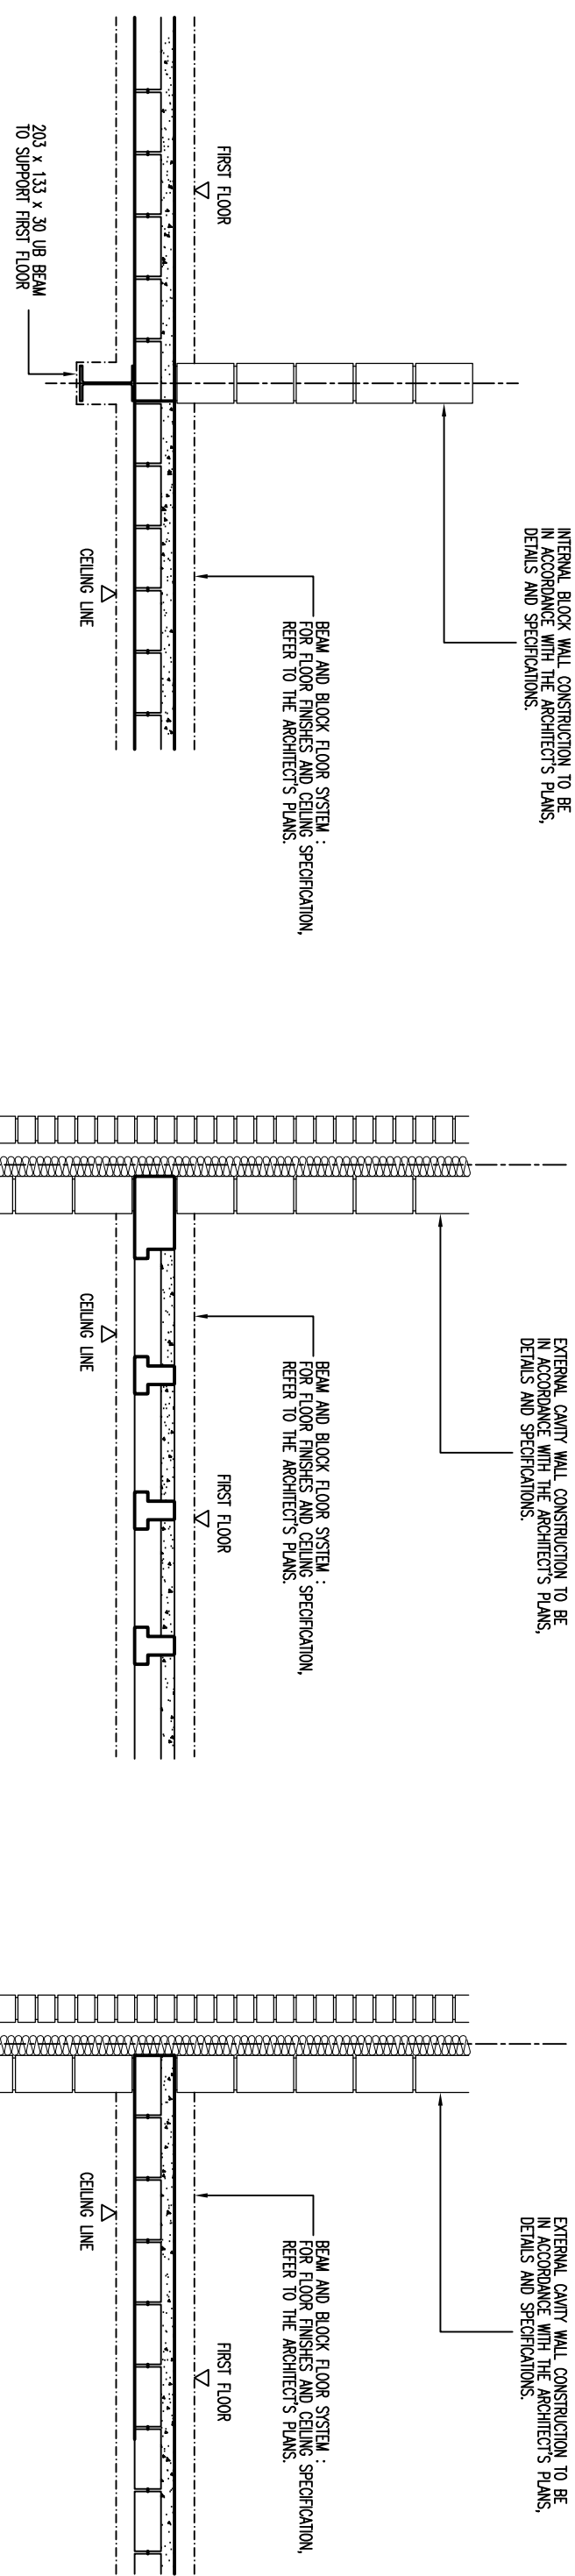[illegible]

## SECTION A-A


## SECTION B-B

## SECTION C-C

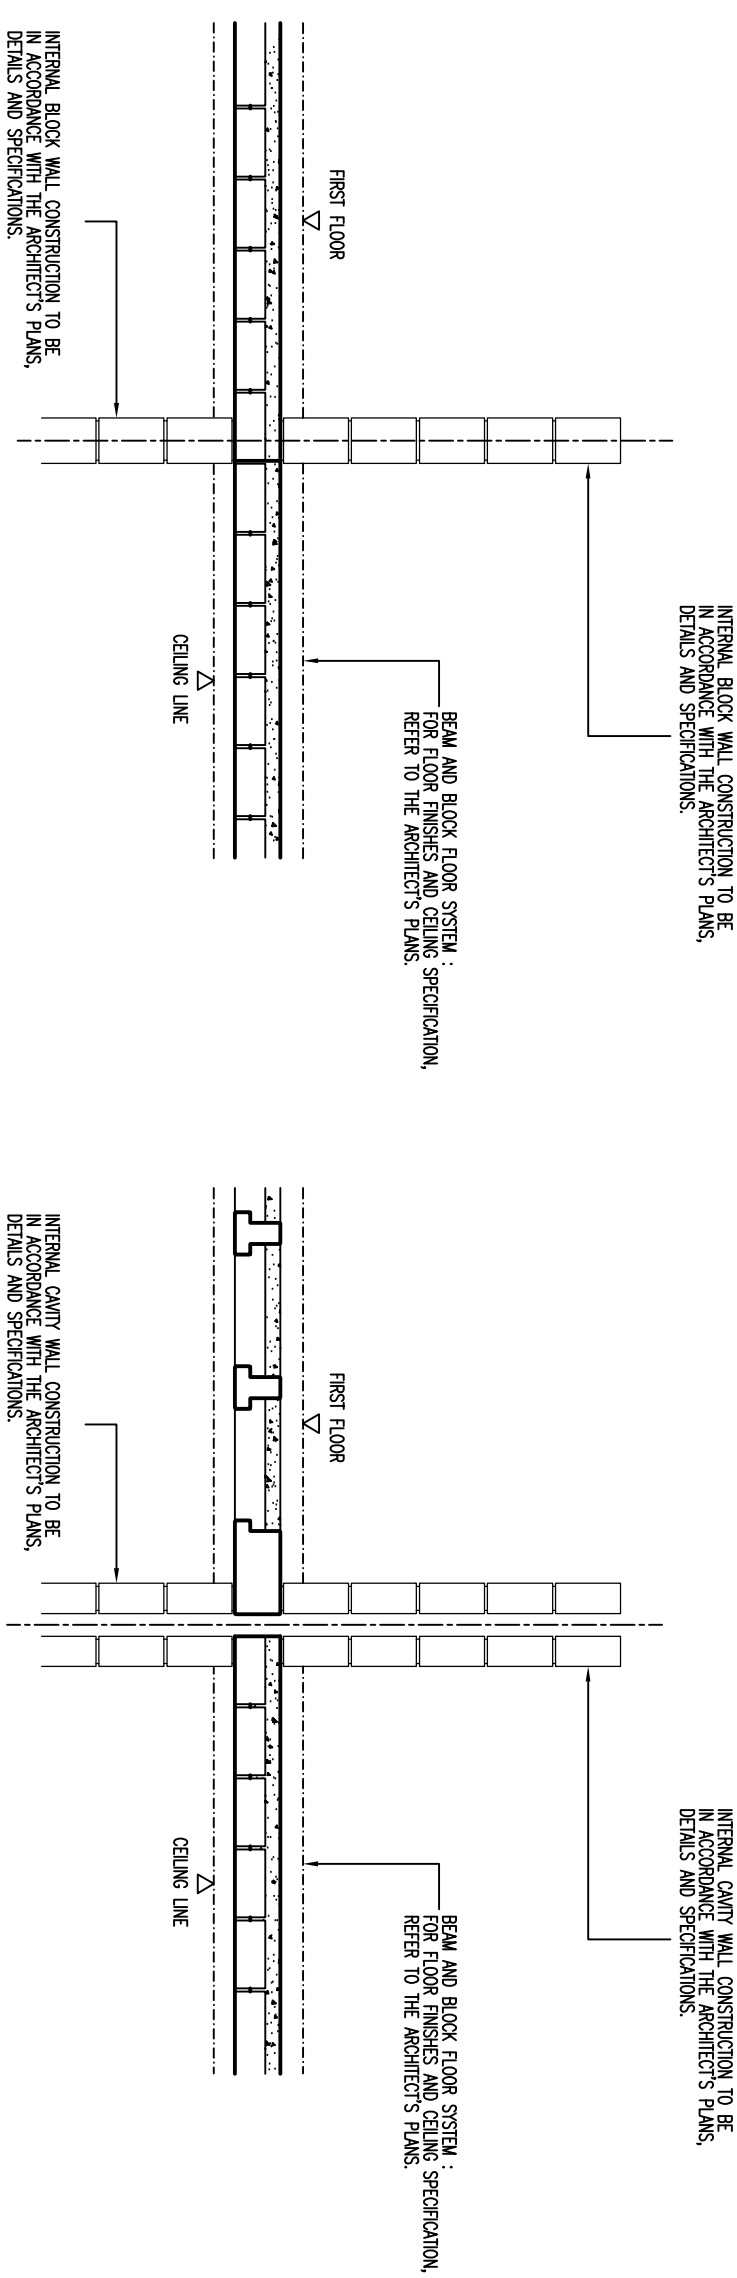

## SECTION D-D

## SECTION E-E

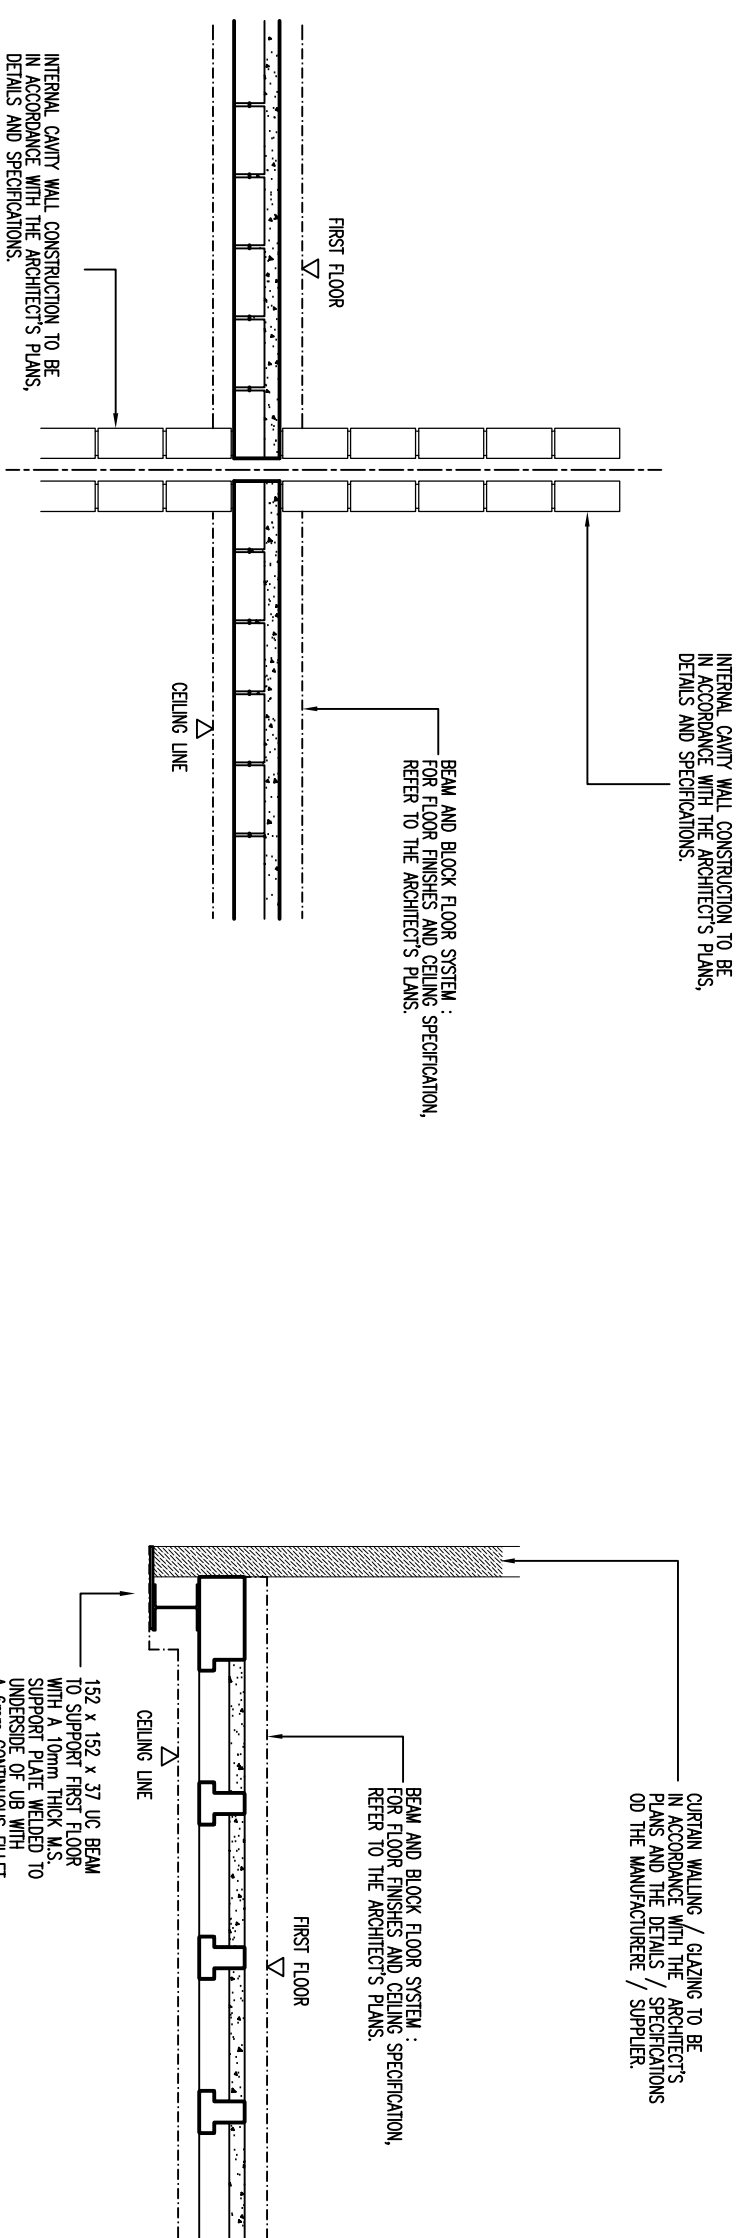

## SECTION F-F

## SECTION G-G

# AS BUILT

**SMART ASSOCIATES**  
Consulting Civil & Structural Engineers

 32 Lambourne Crescent TEL: 029 20754321  
Cardiff Business Park  
Ilanishen, Cardiff  
CF14 5GG [www.smartassociates.biz](http://www.smartassociates.biz)

DEVELOPMENT AT  
HARRISON DRIVE  
CARDIFF

## FIRST FLOOR STRUCTURAL PLAN AND DETAILS

Series	1-100 PLAN & 152 DETAILS @ A1	Drawing Number	REV
Drawn	ov	Checked	
Client	ENCON CONSTRUCTION	Date	02 OCT 2018
Architect	DAVIES LLEWELYN AND JONES		
		S.7683-30	F