
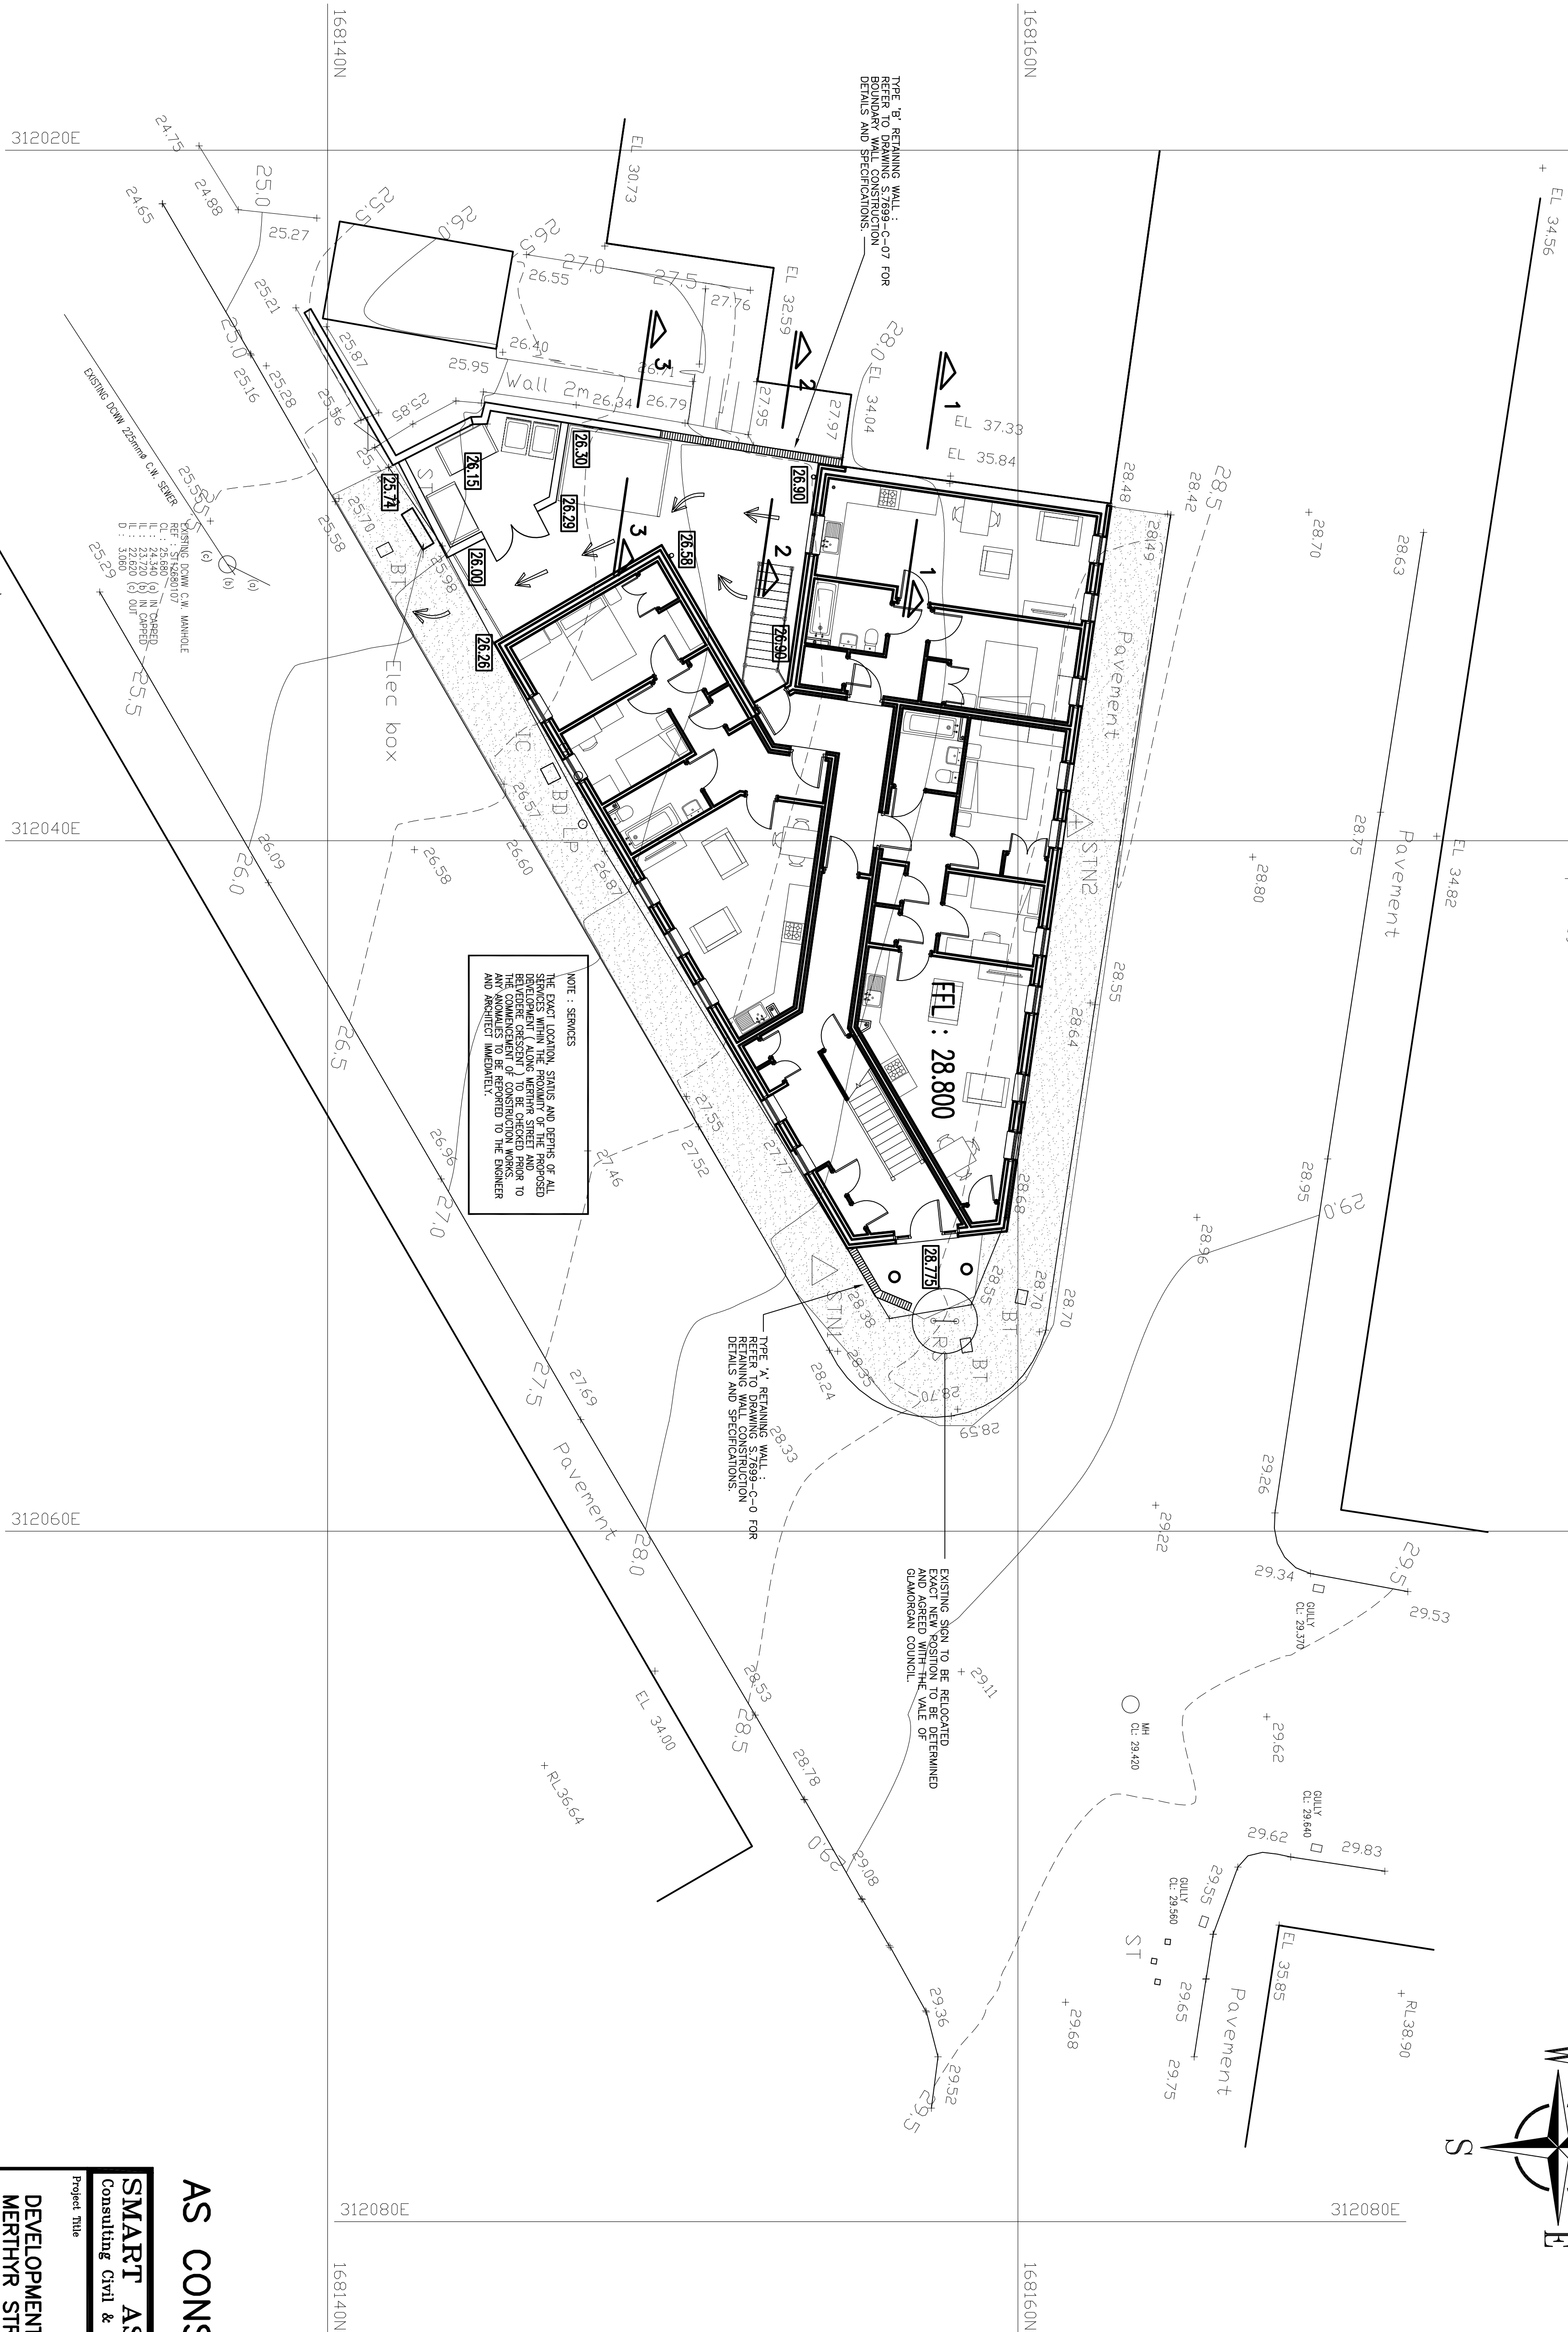


- ## NOTES
1. This drawing is copyright.
  2. All dimensions are to be checked prior to construction or manufacture. Any discrepancy to be reported to the Engineers immediately.
  3. Do not scale this drawing, work to figured dimensions only.

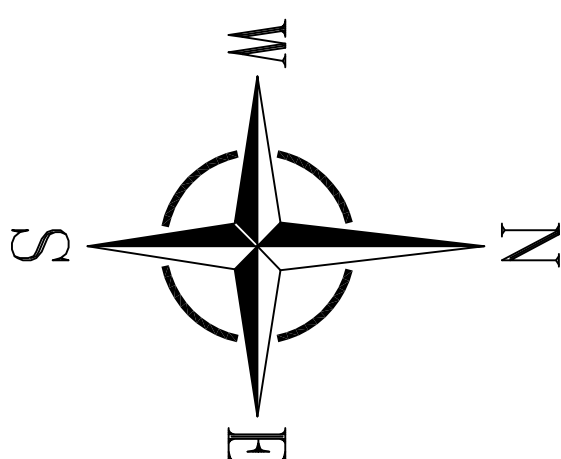

EXTENT OF EXISTING PUBLIC FOOTPATH TO BE RESURFACED. ALL TO BE IN ACCORDANCE WITH AND THE APPROVAL OF THE VALE OF GLAMORGAN COUNCIL.

NOTES :

- i. REMOVE TOP 40mm OF FOOTPAINT SURFACE.
- ii. WHERE EXISTING FOOTPAINT IS TO REMAIN, SAW CUT EXISTING FOOTPAINT SURFACE TO REMOVE CRACKED EDGES TO ALL FACES BETWEEN EXISTING AND PROPOSED.
- iii. ALL EXPOSED FACES SHALL BE COATED WITH BITUMINOUS SPRAY PRIOR TO RESURFACING TAKING PLACE.
- iv. NEW 40mm THICK SURFACE COURSE TO BE APPLIED, (SPECIFICATION AS BELOW ).


FOOTPATH SURFACE COURSE SPECIFICATION :

10mm THICKNESS OF STONE MASTIC ASPHALT SURFACE COURSE SHALL BE 10mm AGGREGATE WITH A MINIMUM PSY OF 68 AND A 1.3mm SURFACE TEXTURE CONFORMING TO BS EN 1308-5 AND SERIE 900 OF THE SPECIFICATION FOR HIGHWAY WORKS, AMENDED AUGUST 2008. (SMA 10 SURFACE COURSE, 40/60 BINDER, PSY SURFACE TEXTURE 1.3mm MAX 14)

NOTE: LIMESTONE AGGREGATE WILL NOT BE PERMITTED IN THE SURFACE COURSE.

PROPOSED DIRECTION OF SURFACE WATER FLOW IN THE EVENT OF EXCEEDANCE OF THE ATTENUATION SYSTEM. GRADIENTS WITHIN THE REAR OPEN SPACE AREA ARE A MAXIMUM OF 1:12.

# AS CONSTRUCTED

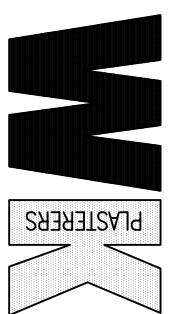

**SMART ASSOCIATES**  
Consulting Civil & Structural Engineers



32 Lambourne Crescent TEL: 029 20754321  
Cardiff Business Park  
Llanishen, Cardiff  
CF14 5GG [www.smartassociates.biz](http://www.smartassociates.biz)

Project Title

Drawing Title

DEVELOPMENT AT  
MERTHYR STREET  
BARRY

### SITE LAYOUT PLAN : EXTERNAL LEVELS

[illegible]

Scale:	1:100 @ A1	Drawing Number	REV
Drawn	or	Checked	
Client	WM PASTERES UNITED	Date	08 AUG 2019
Architect	TONY KING ARCHITECTS	S.7699-C-03	
		b	